


T.1 N. R.39 E. W.M.

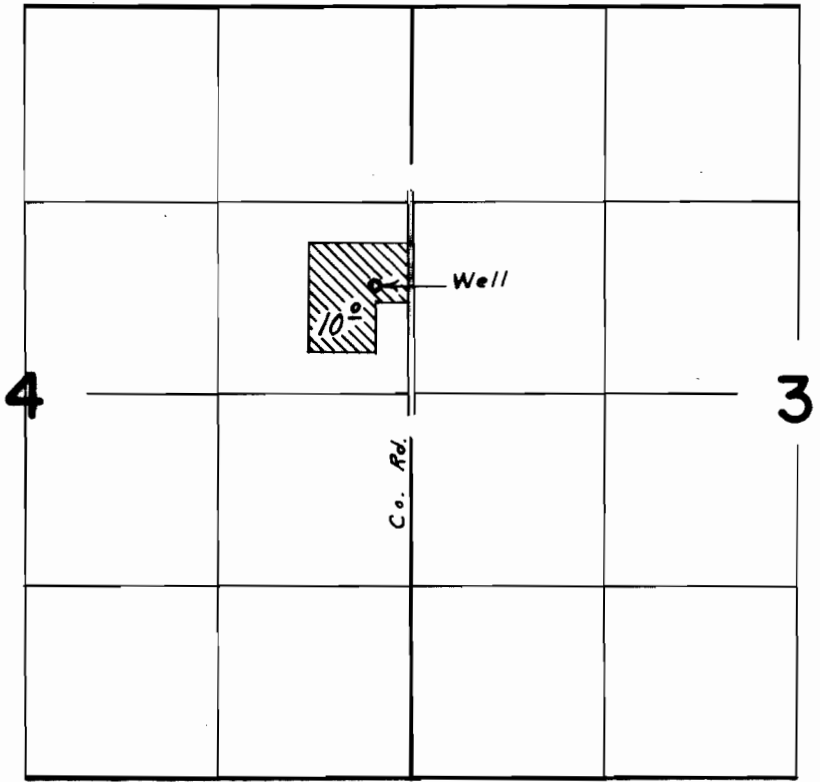

Well located 1920' S. & 240' W. from N.E. Cor. Sec. 4

FINAL PROOF SURVEY
UNDER

Application No. ~~G-4906~~ Permit No. ~~G-4625~~
IN NAME OF
GLEN O. DOUD

Surveyed Aug. 1, 1973, by L. E. Gould.