
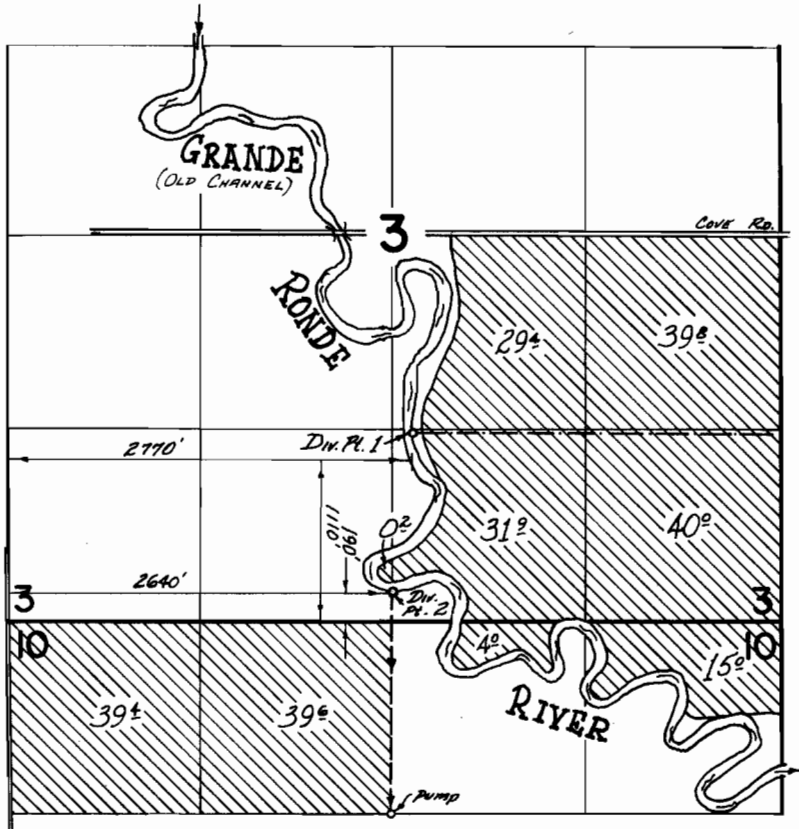


T.3S., R.39E., W.M.

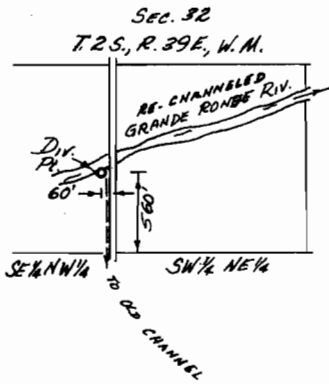

FINAL PROOF SURVEY UNDER

Application No. 41602 Permit No. 31347
IN NAME OF

MERTON TAYLOR

Surveyed July 14 1973 by D. Norby