


T.1N. R.39E. W.M.

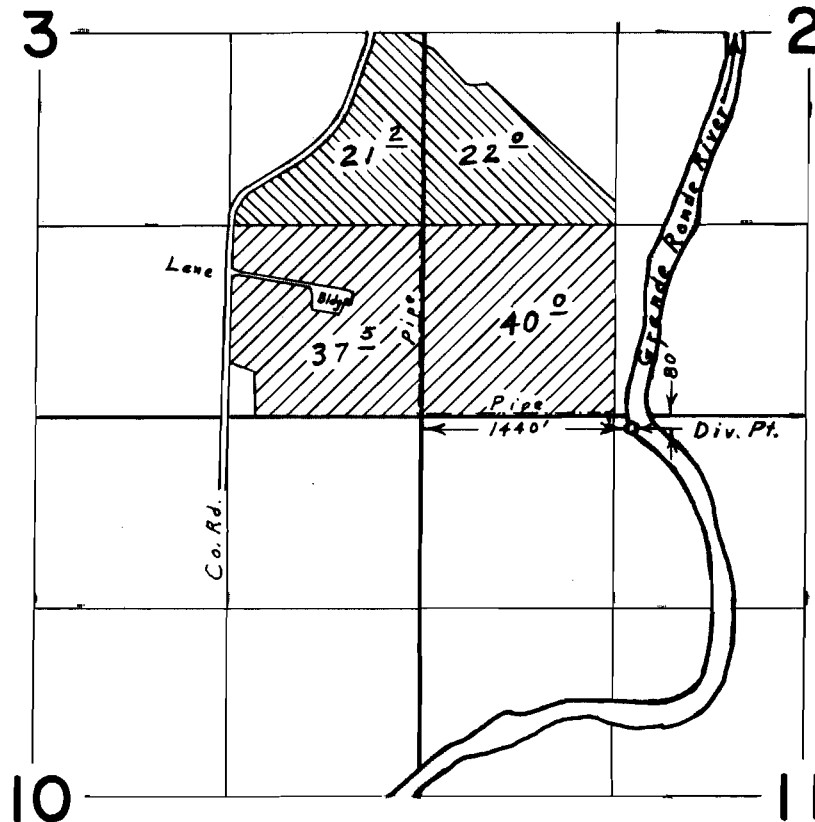

FINAL PROOF SURVEY
UNDER

Application No. 45209 43939 Permit No. 33774 32832 
IN NAME OF

L. R. DENNY

Surveyed July 31, 1973, by L. E. Gould.