


T.1N. R.38E. W.M..

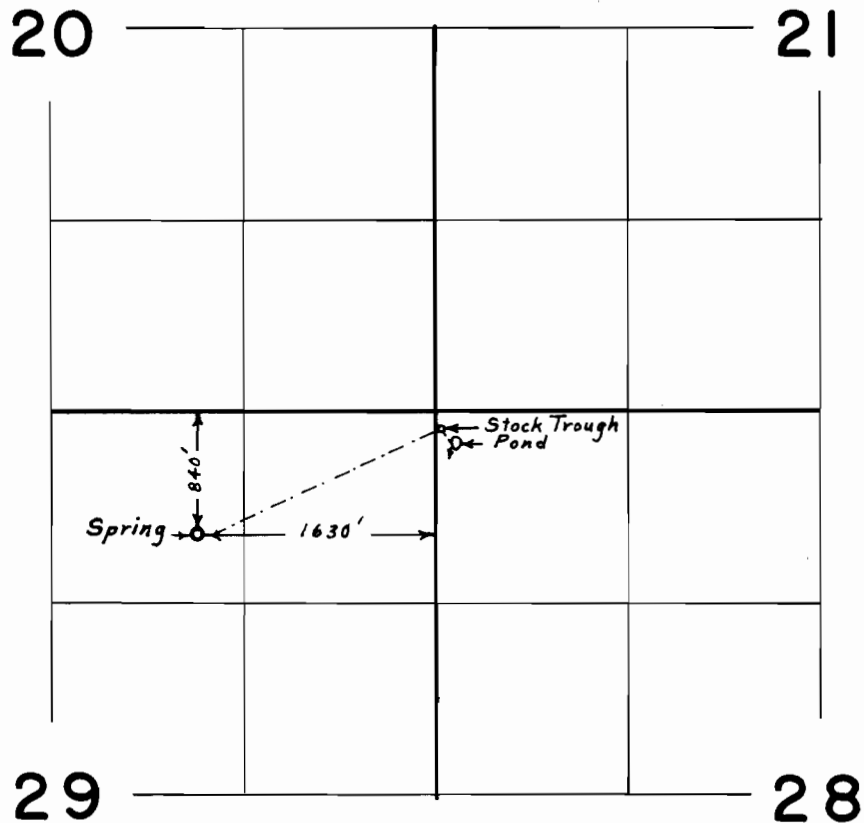

FINAL PROOF SURVEY
UNDER

Application No. 45094 Permit No. 33700
IN NAME OF
JOE L. SCOTT

Surveyed Aug. 2, 1973, by L. E. Gould