


T.1N. R.39E. W.M.

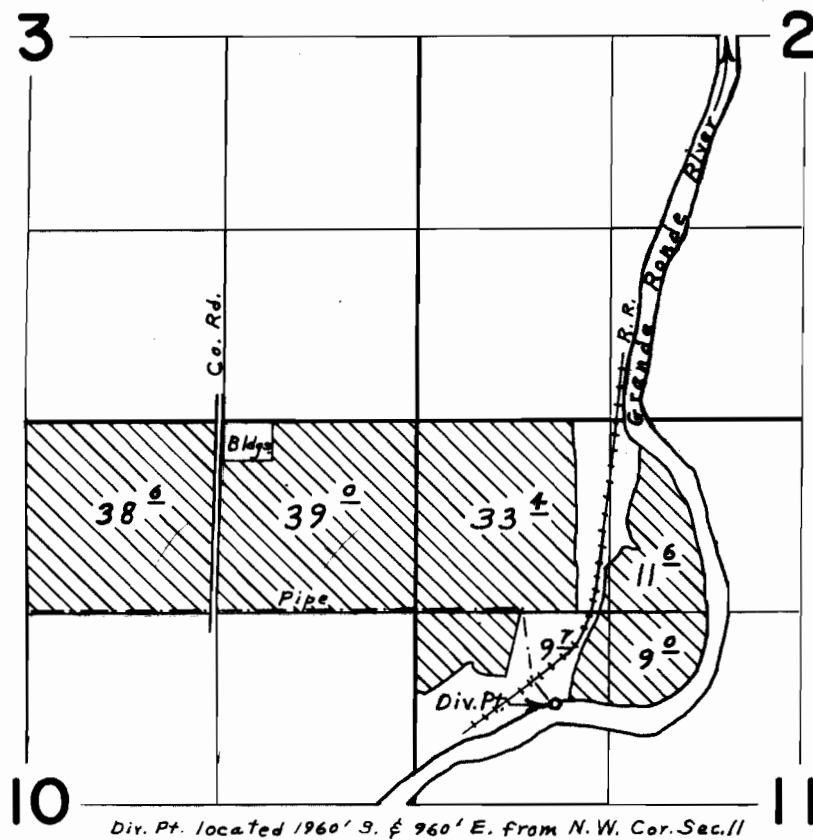

FINAL PROOF SURVEY
UNDER

Application No. 46110 Permit No. 34449
IN NAME OF

J. A. MORGAN

Surveyed July 31, 1973 by L. E. Gould