


T.3S.,R.38E.,W.M.

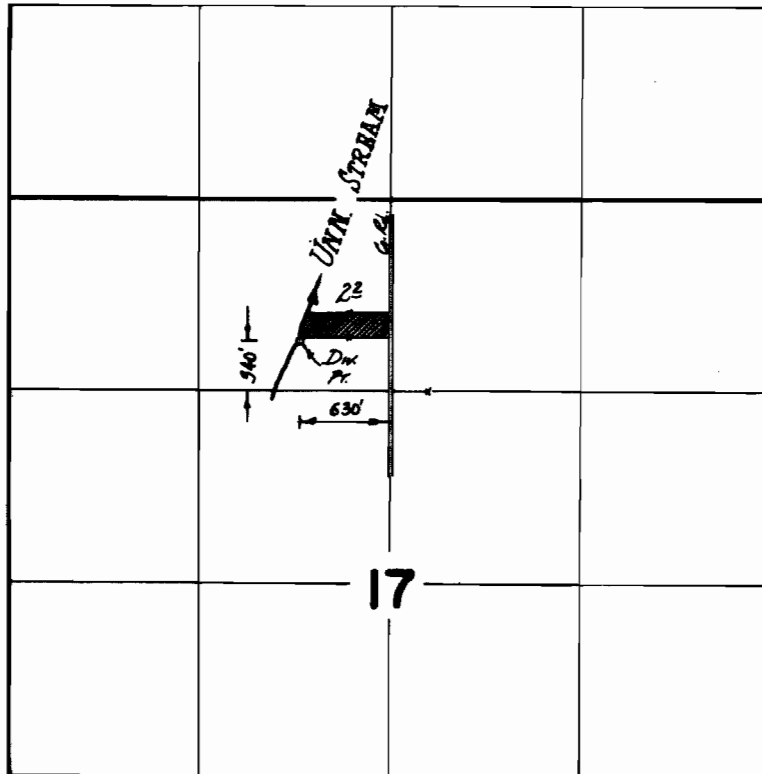

FINAL PROOF SURVEY
UNDER

Application No. 48597 Permit No. 36460
IN NAME OF

LUCILLE GORHAM

Surveyed July 14, 1973, by D. NORBY