


T.3S.,R.40E.,W.M.

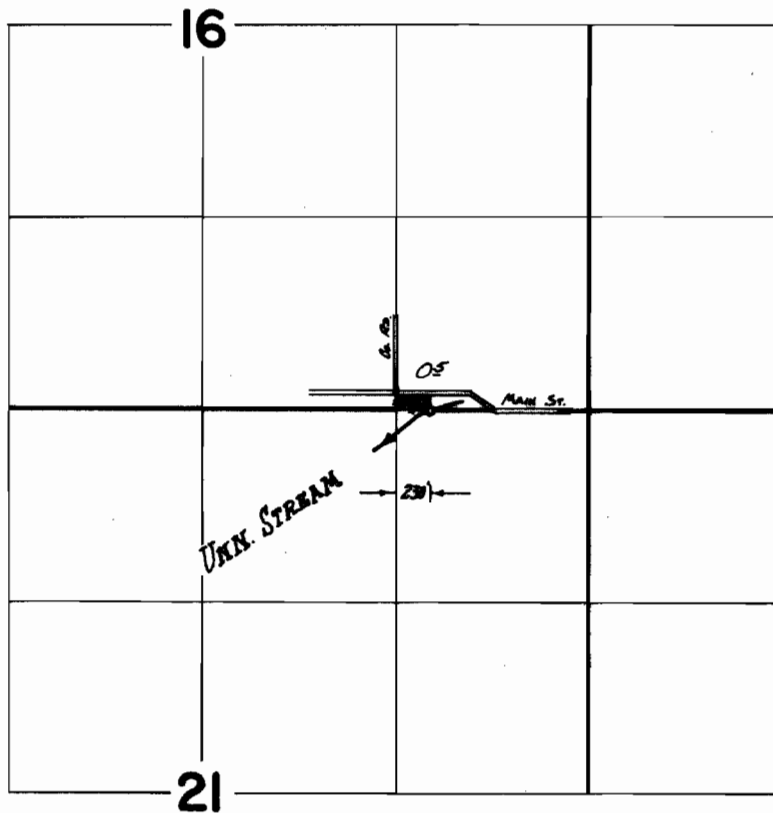

FINAL PROOF SURVEY
UNDER

Application No. 48629 Permit No. 36477
IN NAME OF

WALTER E. TAYLOR

Surveyed July 12 1973, by D. NORBY