


# T.1N.R.48E.W.M.

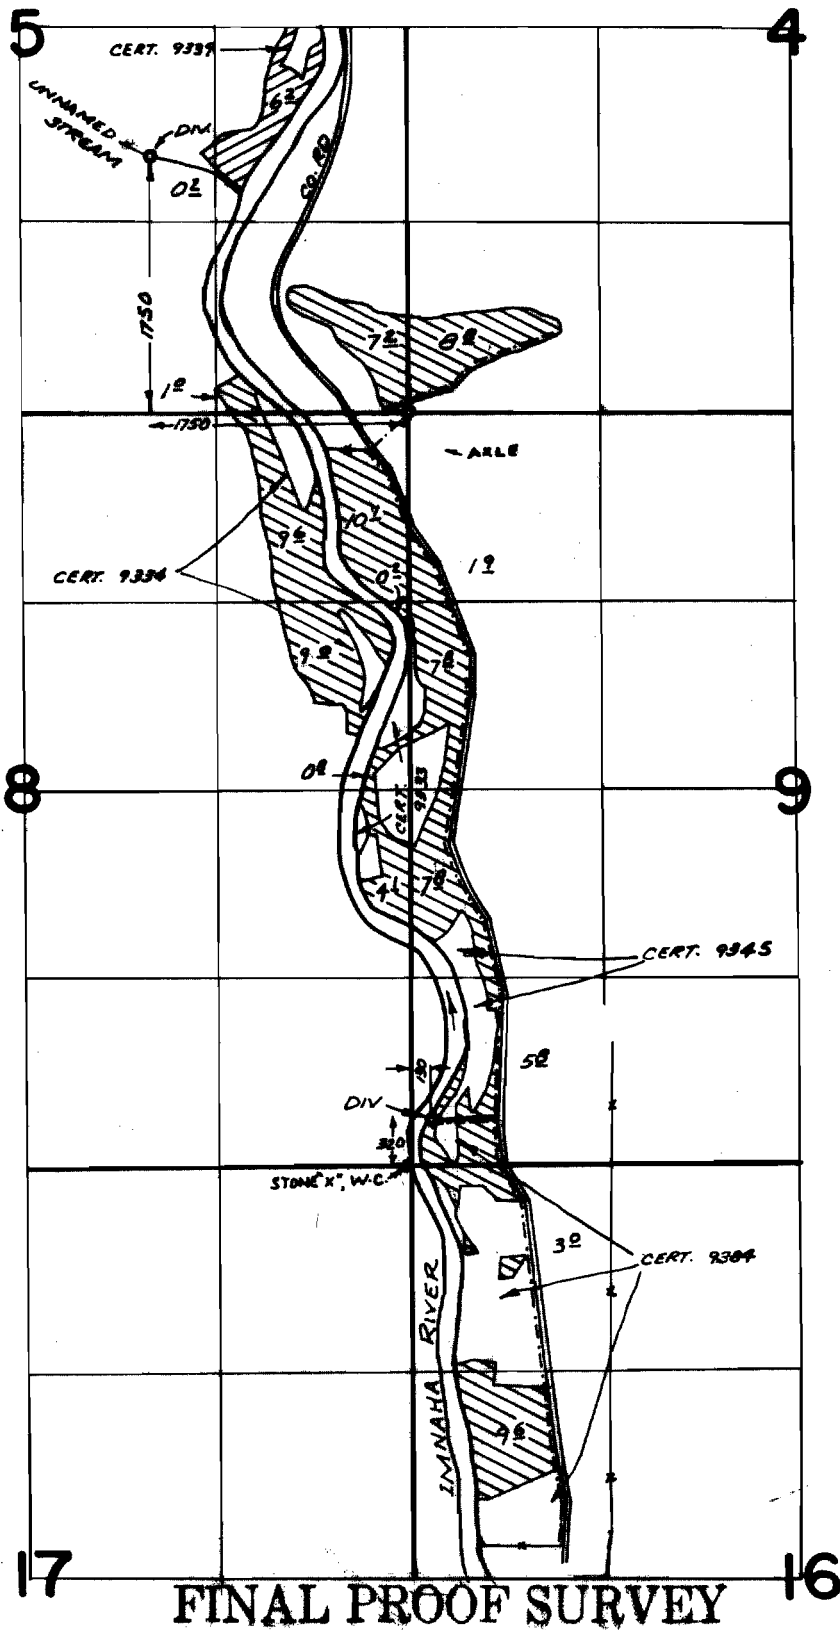

UNNAMED STREAM   
IMNAHA RIVER 

**FINAL PROOF SURVEY**  
**UNDER**  
Application No. ~~45503~~ Permit No. ~~33960~~  
**IN NAME OF**  
K. G. BENTSON  
~~SURVEYED~~ **AUG. 6, 1973**, by R. MUCKEN