


T.1S.R.2W.W.M.

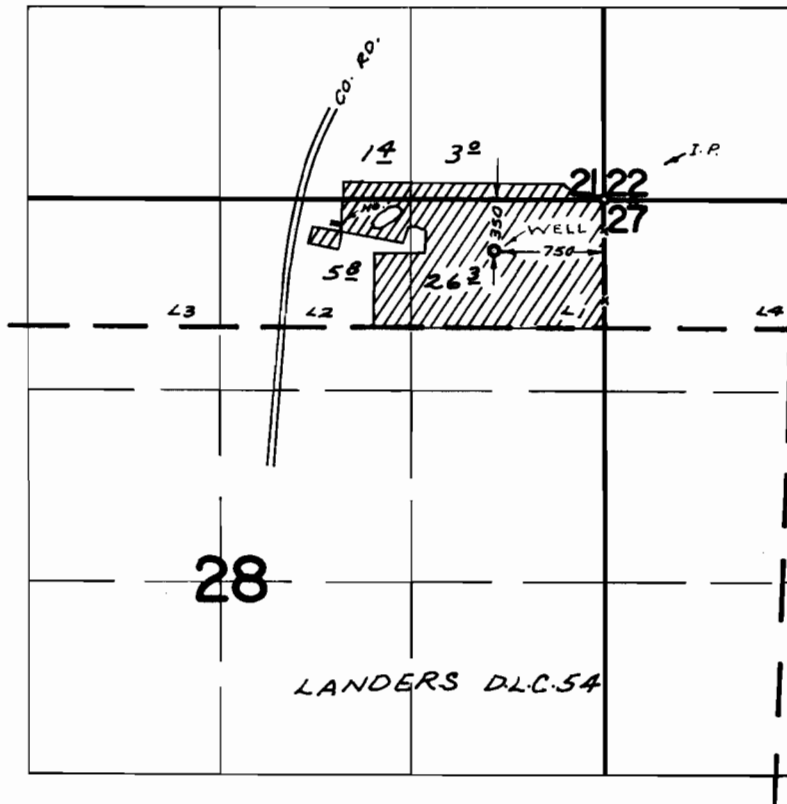

FINAL PROOF SURVEY
UNDER

Application No. G-3373 Permit No. G-3177
IN NAME OF

D. L. WATTS

Surveyed Nov. 3, 1972, by R. MUCKEN