T. 2 N. R. 3 W. W. M.

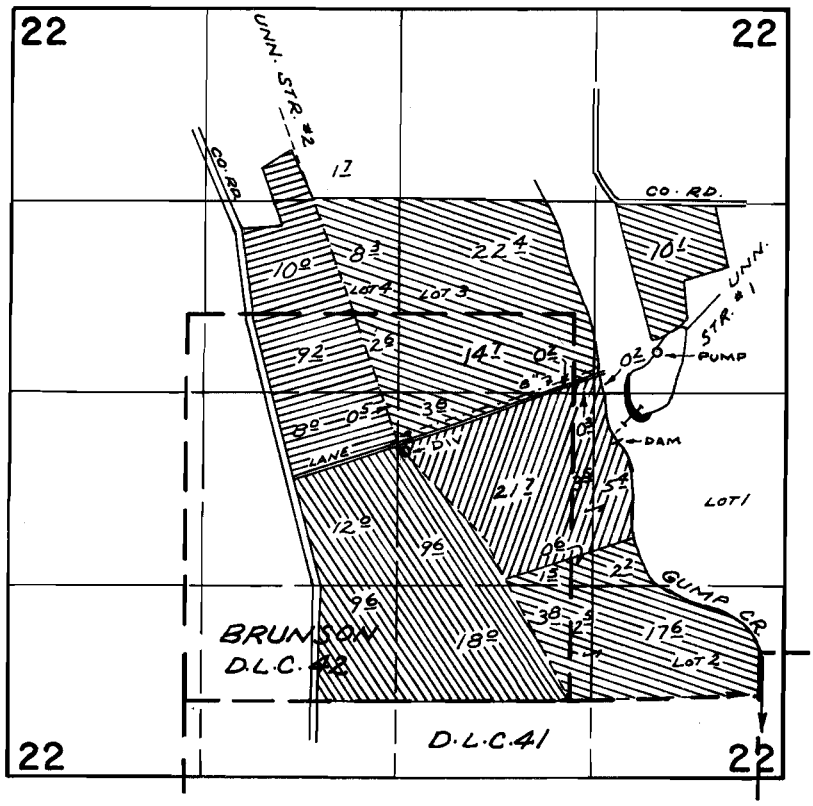

DIV. PT. LOC: UNN. STR. #1 - 150'S & 1050'W ; UNN. STR. #2 - 400'S & 2600'W, BOTH FROM E¼ COR. SEC. 22

PRIM. UNN. STR. #2

PRIM. RES. & UNN. STR. #1

PRIM. RES. & UNN. STR #1 & #2

SUPPL. RES. & UNN. STR #1

FINAL PROOF SURVEY

UNDER

Application No. R-43940 43941 Permit No. R-4961 32363

IN NAME OF

ROBERT KAUER, JR.

Surveyed APR. 3, 1974, by R. MUCKEN

DFR-2D-177 & DBS-4LL-61