


T. 3N.R.3W. W.M.

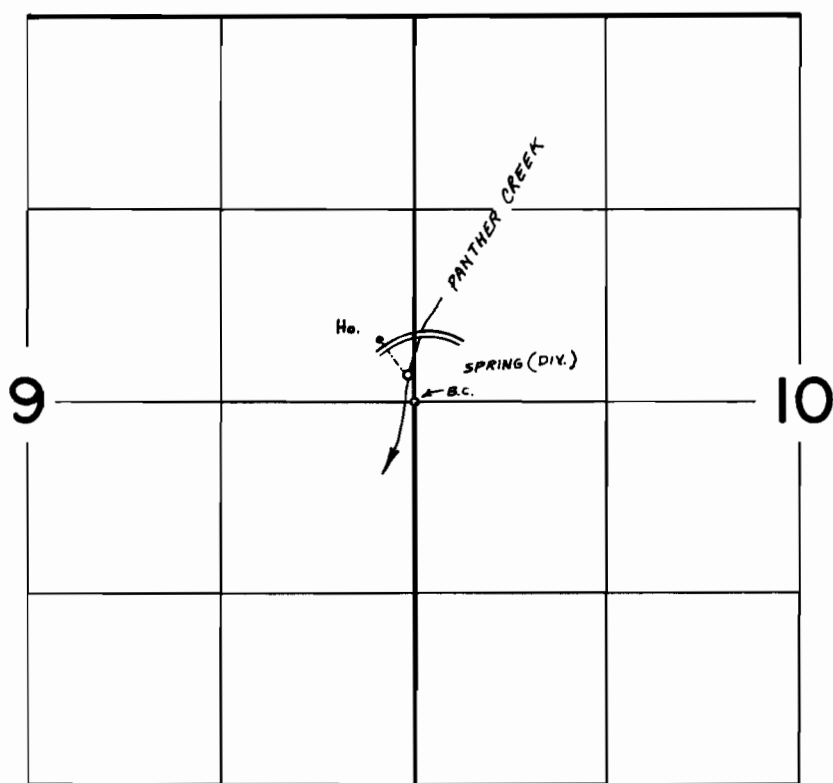

SPRING LOCATED 160' N & 60' W FROM E $\frac{1}{4}$ Cor. Sec. 9

FINAL PROOF SURVEY
UNDER

Application No. 47450 Permit No. 35549
IN NAME OF

TIMOTHY G. WAHLBERG

Surveyed JUN 28 1973, by R.G. MUCKEN