


T.5S. R.3E. W.M.

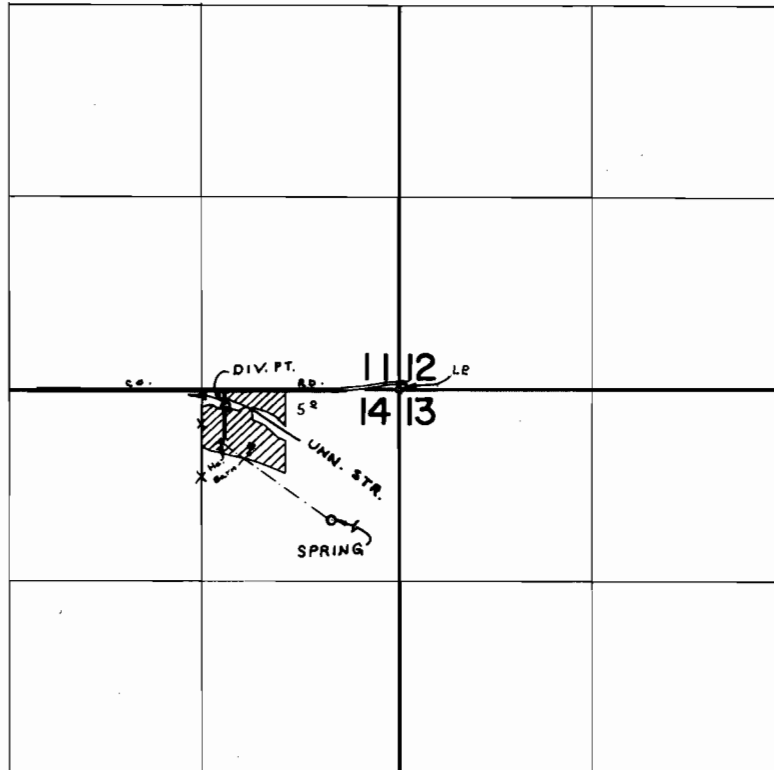

Div. Pt. Loc: 110'S. & 1190'W. from NE cor. Sec. 14
Spring Loc: 900'S. & 470'W. from NE cor. Sec. 14

FINAL PROOF SURVEY
UNDER

Application No. 42839 Permit No. 32019
IN NAME OF

WILLIAM & MARIE NORGREN

Surveyed SEPT. 25, 1973, by R. MUCKEN