


T.4S.R.1E.W.M.

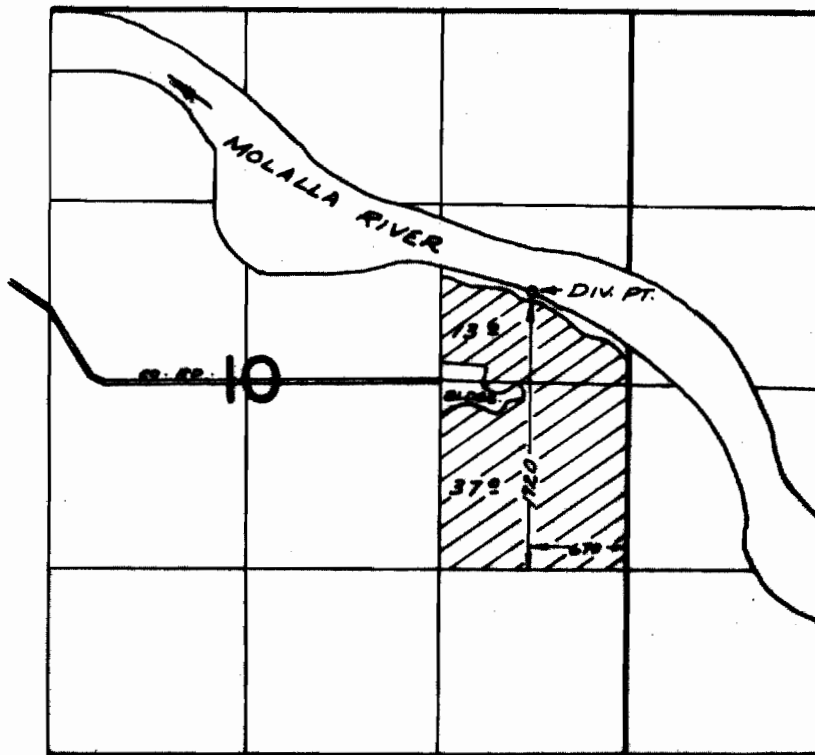

**FINAL PROOF SURVEY
UNDER**

Application No. 45777 Permit No. 34174
IN NAME OF

ROBERT MAY

Surveyed OCT. 26, 1973, by R. MUCKEN