


# T.4N. R.8W. W.M.

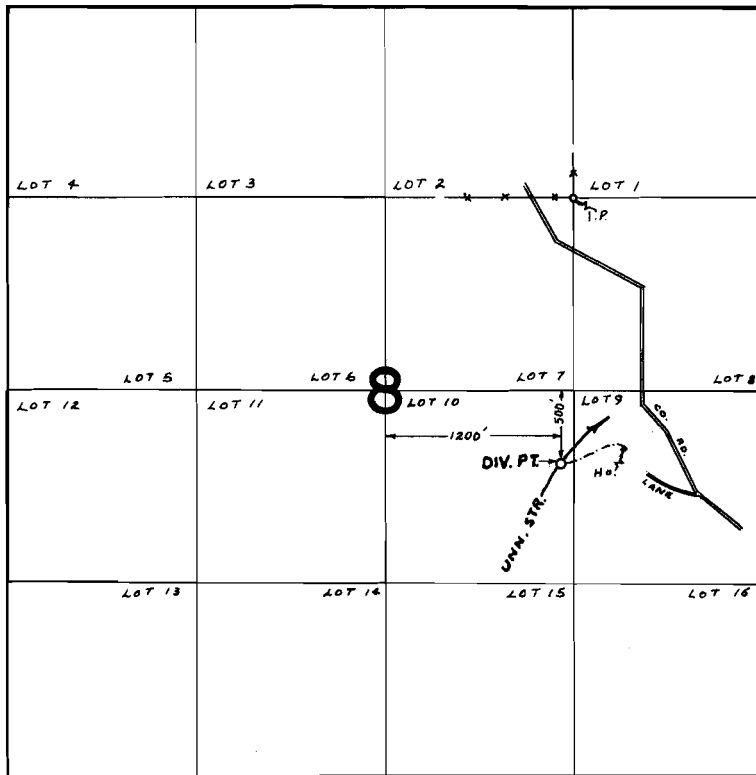

## FINAL PROOF SURVEY UNDER

Application No. 44689 Permit No. 33459  
IN NAME OF

RICHARD F & DOROTHY D. CARMEAN

Surveyed MAY 4, 1973, by R. MUCKEN