


T.4N. R.9W. W.M.

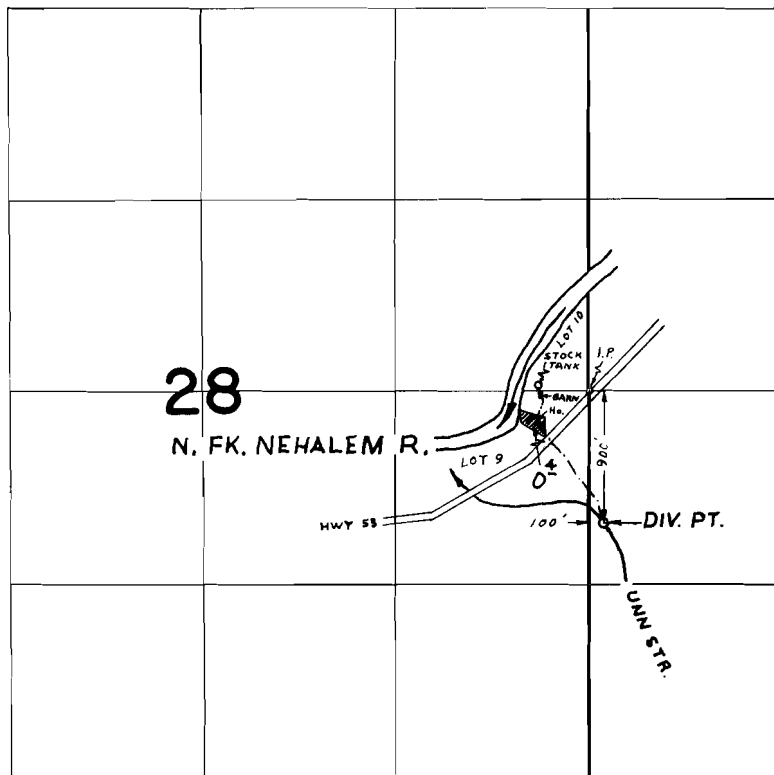

FINAL PROOF SURVEY
UNDER

Application No. 45839 Permit No. 34223
IN NAME OF
LEO LIND

Surveyed MAY 3, 1973, by R. MUCKEN