


T.40S., R.12E., W.M.

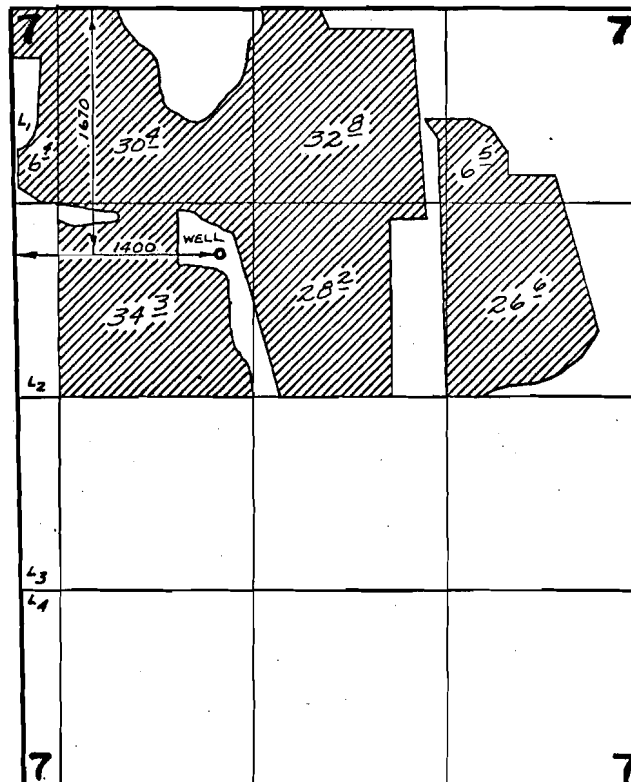

FINAL PROOF SURVEY

UNDER

Application No. G-3259 Permit No. G-3057
IN NAME OF

LLOYD D. & SUZANNE M. COGLEY; EARL W.
& ELEANOR I. NIDEVER; & ROBERT W. & ARLEEN E. NIDEVER

Surveyed Oct. 17, 1972, by D. Norby