


T. 19 S. R. 3 W. W.M.

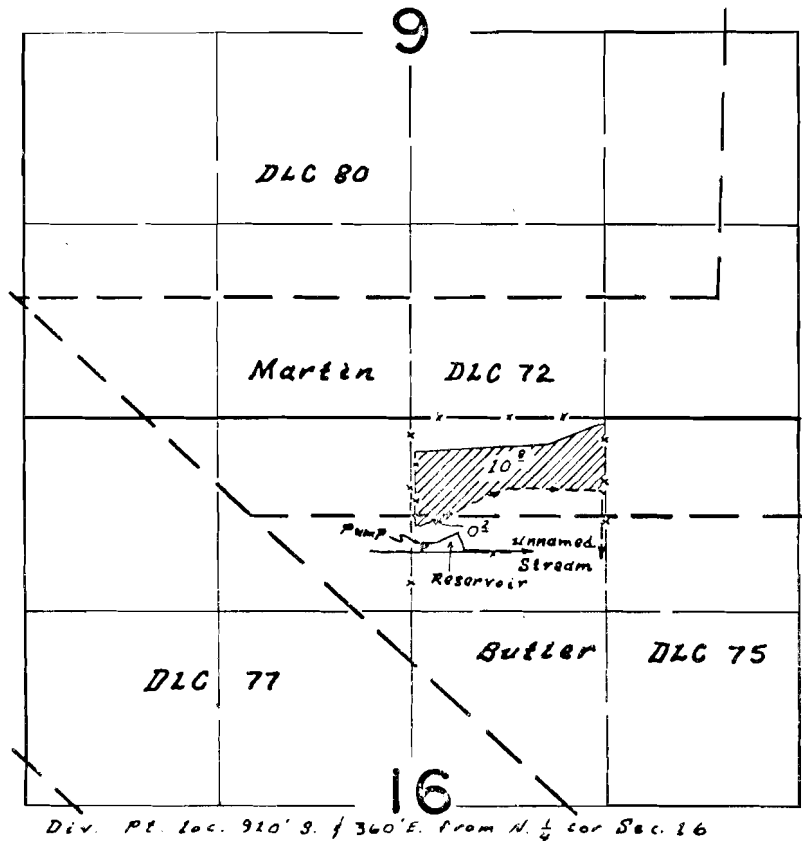

FINAL PROOF SURVEY
UNDER

R-42701

R-4846

Application No. 42702 Permit No. 31906
IN NAME OF

Leroy Bowers

Surveyed 31 May 1972, by L.E. Gould