


T.6S., R.10W., W.M.

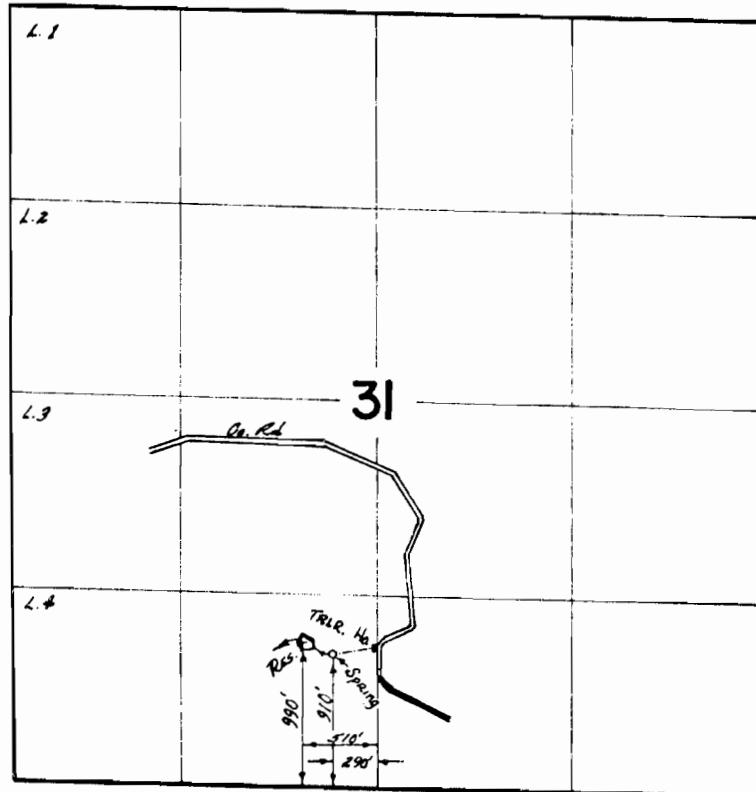

FINAL PROOF SURVEY  
UNDER

R-44423 R-5146  
Application No. 44424 Permit No. 33180  
IN NAME OF

FRANK Jr. & ERMA L. HUNTER

Surveyed SEPT. 4 1973, by D. NORBY