


T.6S.,R.10W.,W.M.

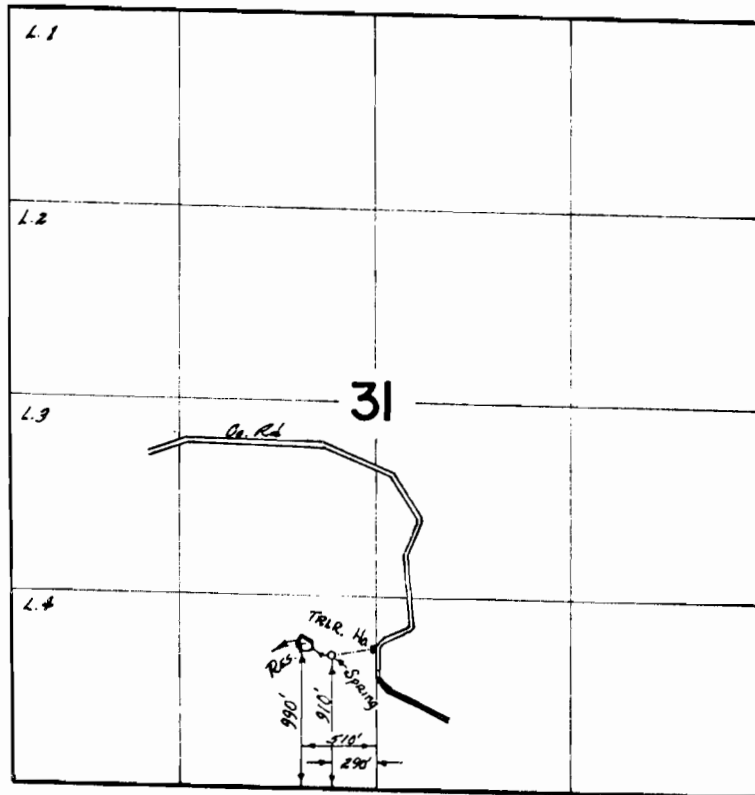

FINAL PROOF SURVEY
UNDER

R-44423 R-5146
Application No. 44424 Permit No. 33180
IN NAME OF

FRANK Jr. & ERMA L. HUNTER

Surveyed Sept. 4, 1973, by D. Norby