


T.10S.R.10W.W.M.

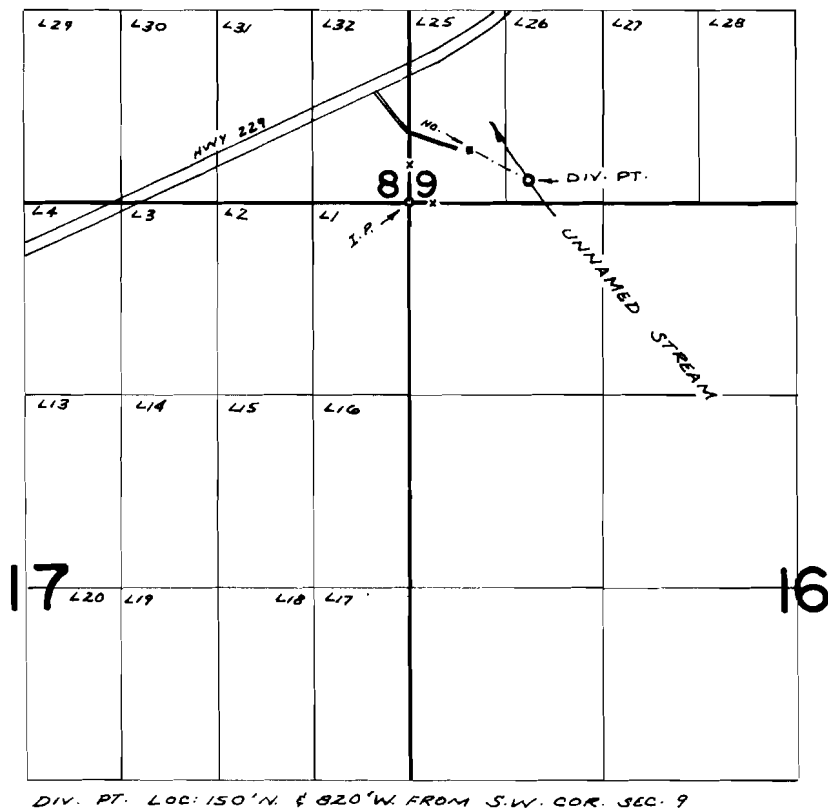

FINAL PROOF SURVEY
UNDER

Application No. 46421 Permit No. 34686
IN NAME OF

Jerry A. & Fredo M. Butler

Surveyed SEPT 19 1973, by R. MUCKEN