


T.6S.,R.10W.,W.M.

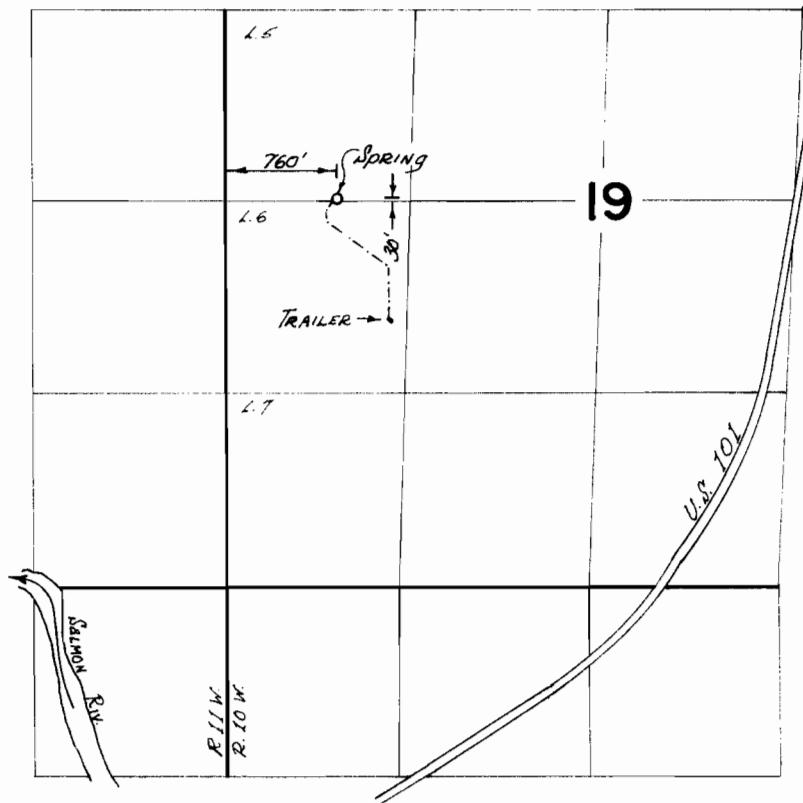

**FINAL PROOF SURVEY**  
UNDER

Application No. 46865 Permit No. 34954  
IN NAME OF

RALPH N. SKIDMORE

Surveyed Sept. 5 1973, by D. Norby