


T.6S.,R.10W.,W.M.

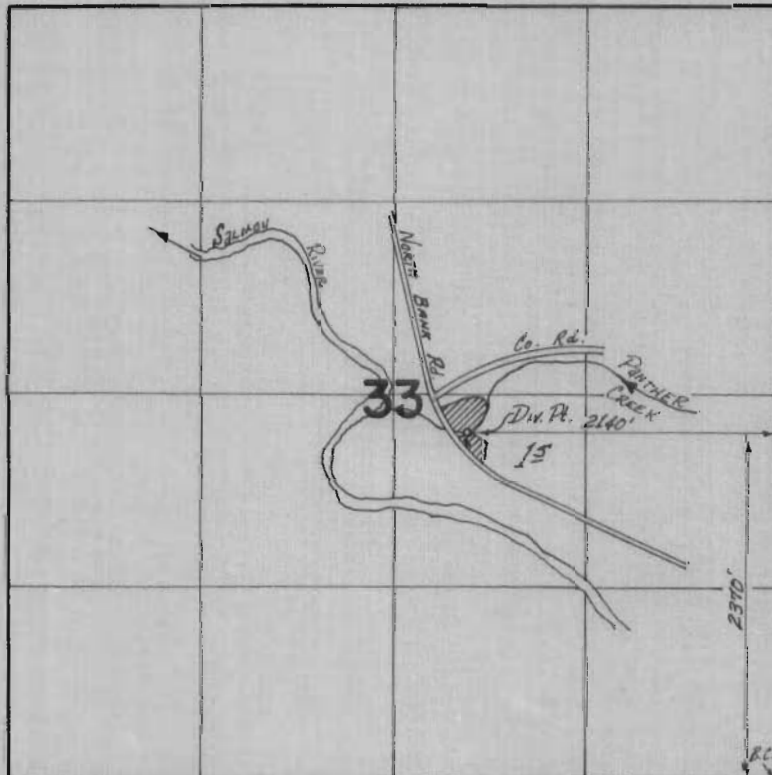

FINAL PROOF SURVEY
UNDER

Application No. 47708 Permit No. 35740
IN NAME OF

LOUISE RYAN LEWIS

Surveyed SEPT. 6 1973, by D. NORBY