


T.6&7S.,R.10W.,W.M.

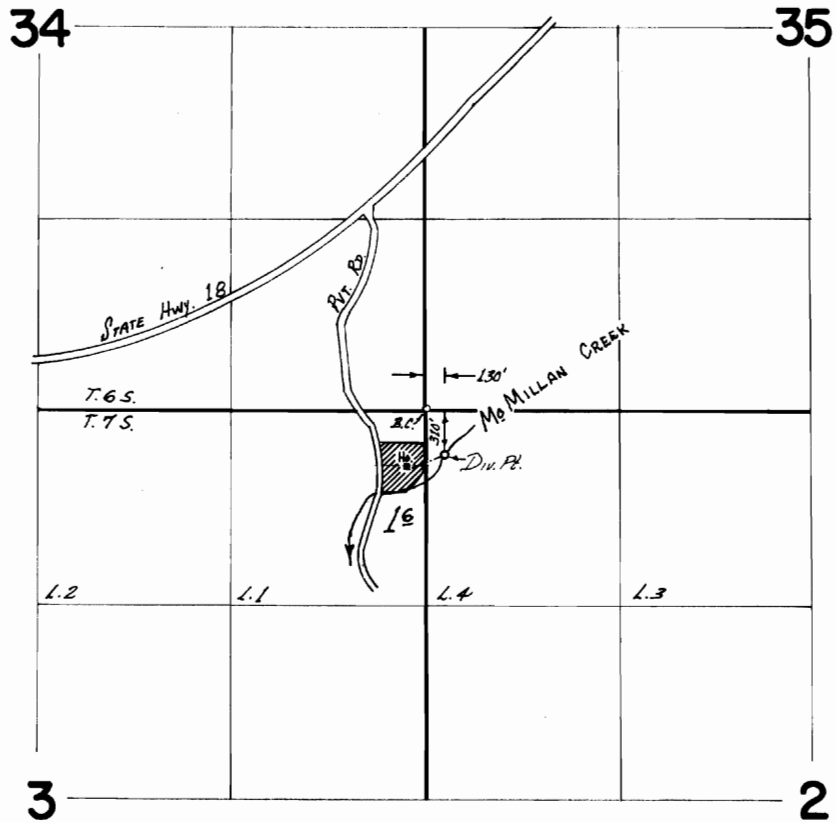

**FINAL PROOF SURVEY**  
UNDER

Application No. 48421 Permit No. 36348  
IN NAME OF

HOMER McMILLIN

Surveyed SEPT. 6 1973, by D. NORRBY