


T.I.O.S., R.I.W., W.M.

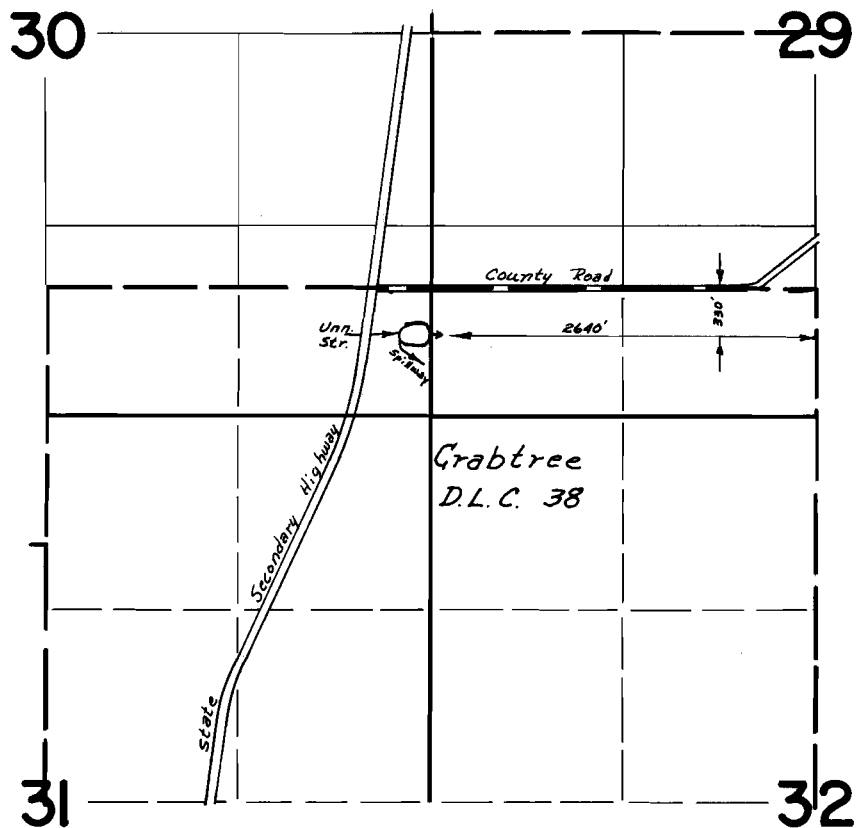

FINAL PROOF SURVEY
UNDER

Application No. R-48601 48602 Permit No. R-5801 35922
IN NAME OF

GORDON C. HARPER

Surveyed Aug. 29 1972, by D. Norby