


T.I.O.S., R.I.W., W.M.

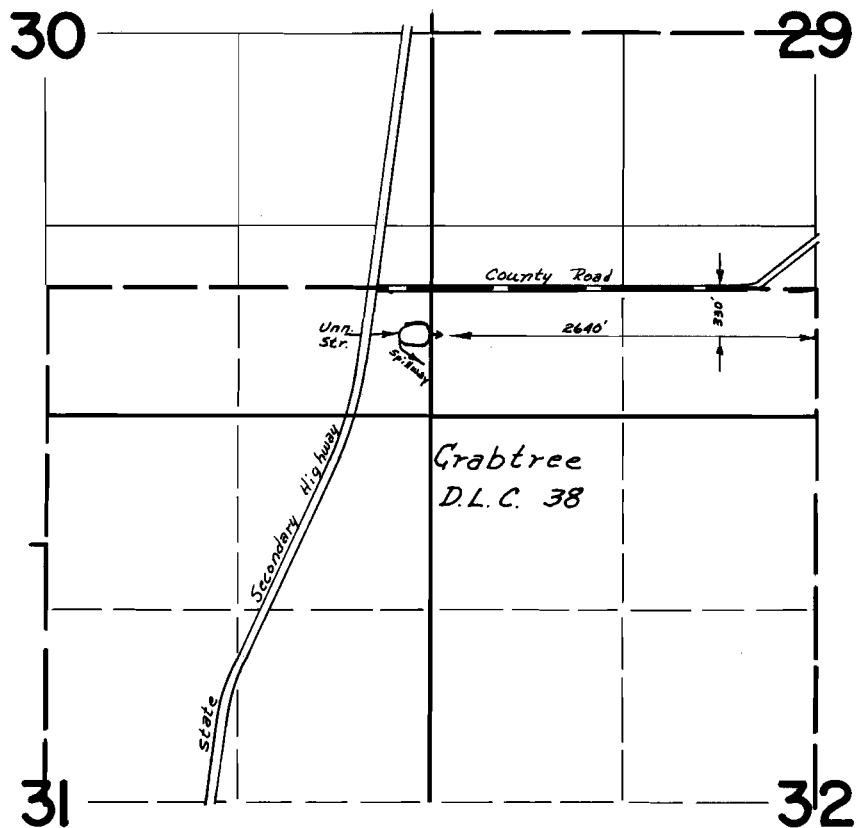

FINAL PROOF SURVEY
UNDER

R-48601 R-5801
Application No. 48602 Permit No. 35922
IN NAME OF

GORDON C. HARPER

Surveyed Aug. 29 1972, by D. Norby