


T.6S. R.2W. W.M.

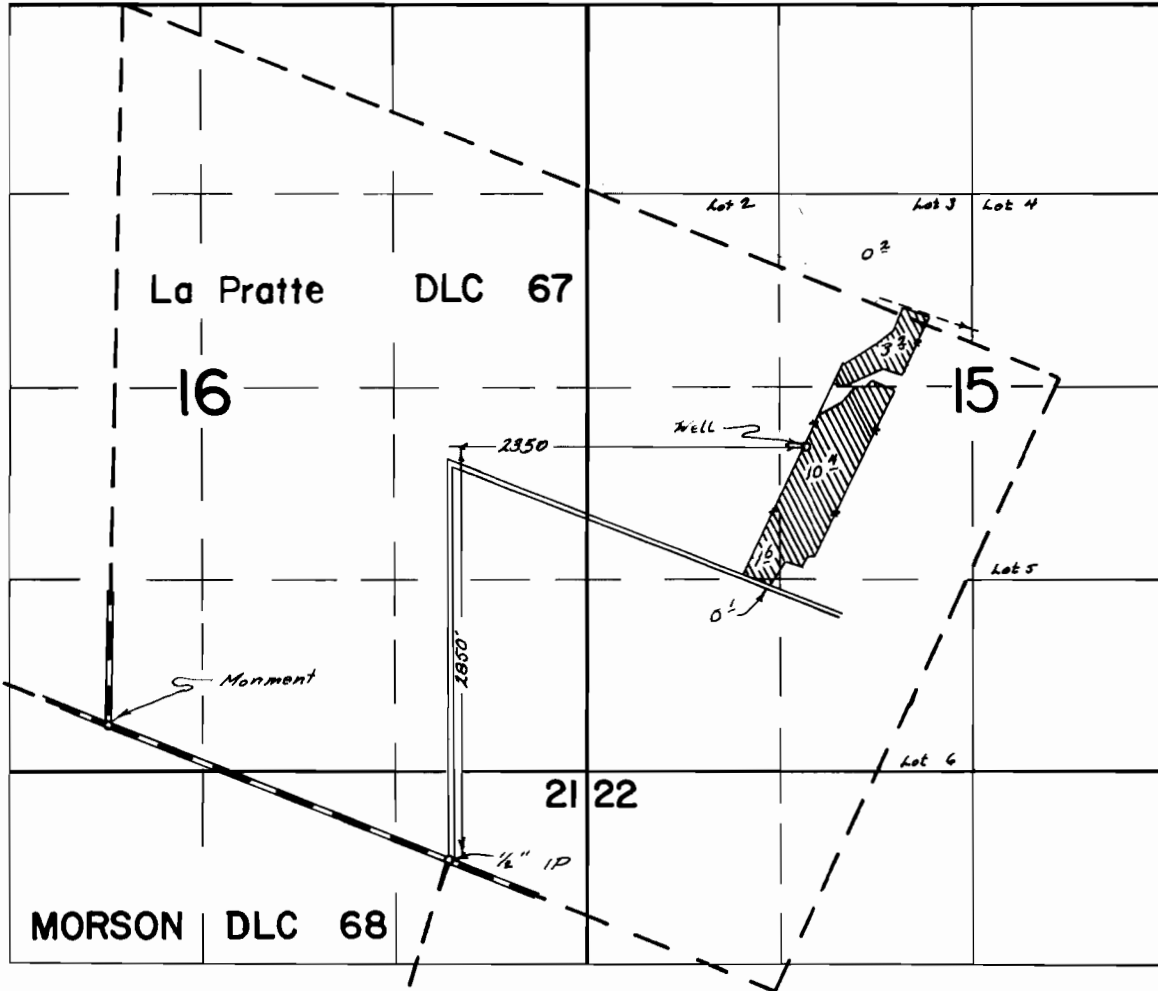

FINAL PROOF SURVEY
UNDER

Application No. G-3523 Permit No. A-3315
IN NAME OF

KENNETH E. POTTERF

Surveyed May 19 1972, by R. G. Mucken