


T.10S.R.6E.W.M.

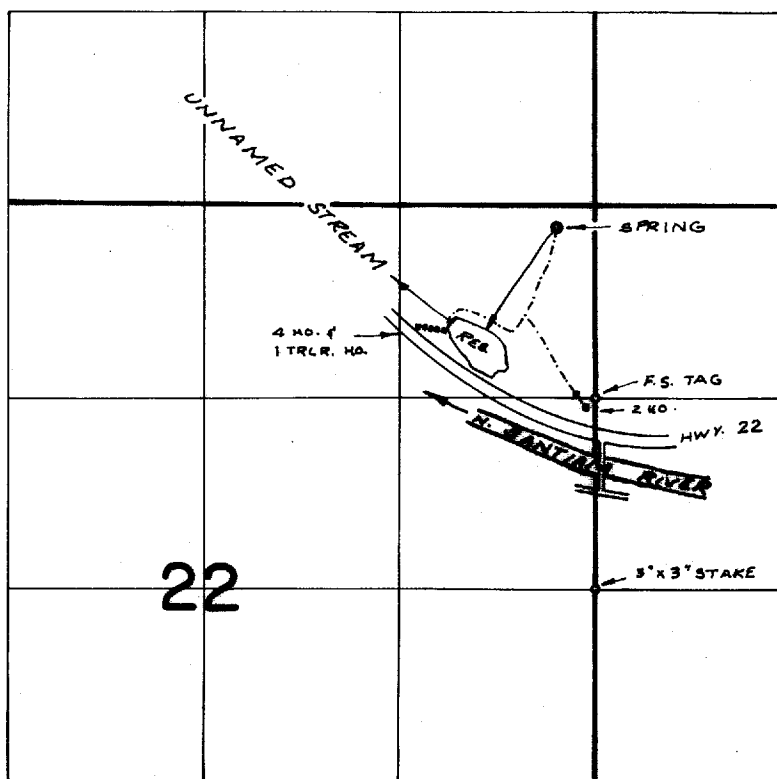

DIV. PTS. LOC: SPRING- 2490'N & 250'W; UNN. STR.
 & RES. - 1840'N. & 970'W, BOTH FROM E & COR. SEC. 22

FINAL PROOF SURVEY UNDER

Application No. R-37094 37045 Permit No. R-3693 27077
 IN NAME OF

ATHOL SAVAGE & WIFE

Surveyed JULY 7 1972, by R. MUCKEN