


G-2312

41011

T.5N.R.35 & 36E.W.M.

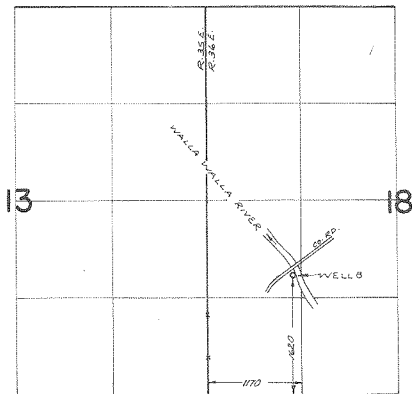

FINAL PROOF SURVEY
UNDER

Application No. *G-2502* Permit No. *G-2312*
IN NAME OF

CITY OF MILTON - FREEWATER

Surveyed *APR 20, 1923*, by *R. MUGGEN*
NOV. 2, 1966 *V. GARNER*