


G-3149
41012

T.6N.R.34E.W.M.

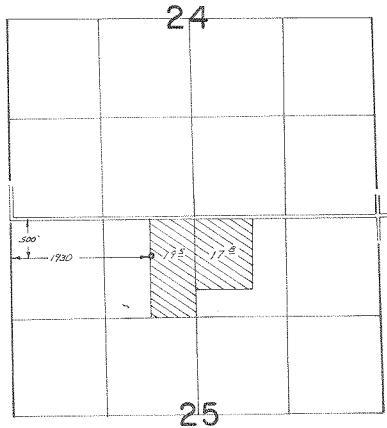

FINAL PROOF SURVEY UNDER

Application No. *G-3356* Permit No. *G-3149*
IN NAME OF

LOWELL MARLATT

Surveyed *APR. 11, 1973*, by *R. MUCKEN*