


6-3228

41013

T.6N.R.36E.W.M.

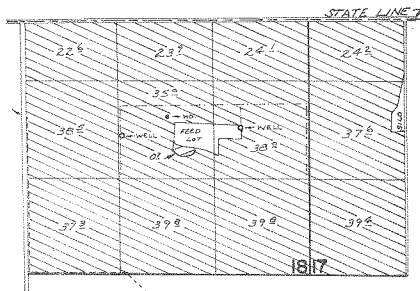

PRIMARY

SUPPLEMENTAL

WELLS LOC: 1880'N & 1350'E; 2000'N & 2990'E, BOTH FROM
SW. COR. SE & SW & SEC. 18

FINAL PROOF SURVEY UNDER

Application No. G-3448 Permit No. G-3228
IN NAME OF

WELDON FERGUSON

Surveyed APR. 12, 1973, by R. MURKIN

NZ-SMM-32