


G-3678
41014

T.4N.R.33E.W.M.

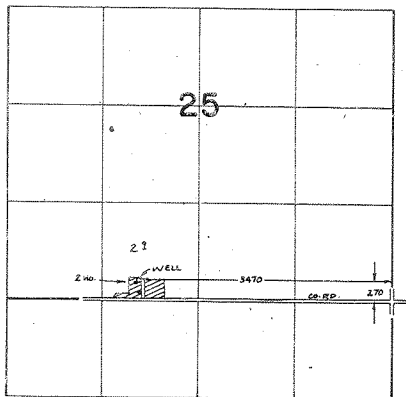

FINAL PROOF SURVEY
UNDER

Application No. G-3215. Permit No. G-3678.
IN NAME OF

.....HOWARD REEDER.....

Surveyed APR. 19, 1973, by R. MACKEN