


T. 4N.R. 35E.W.M.

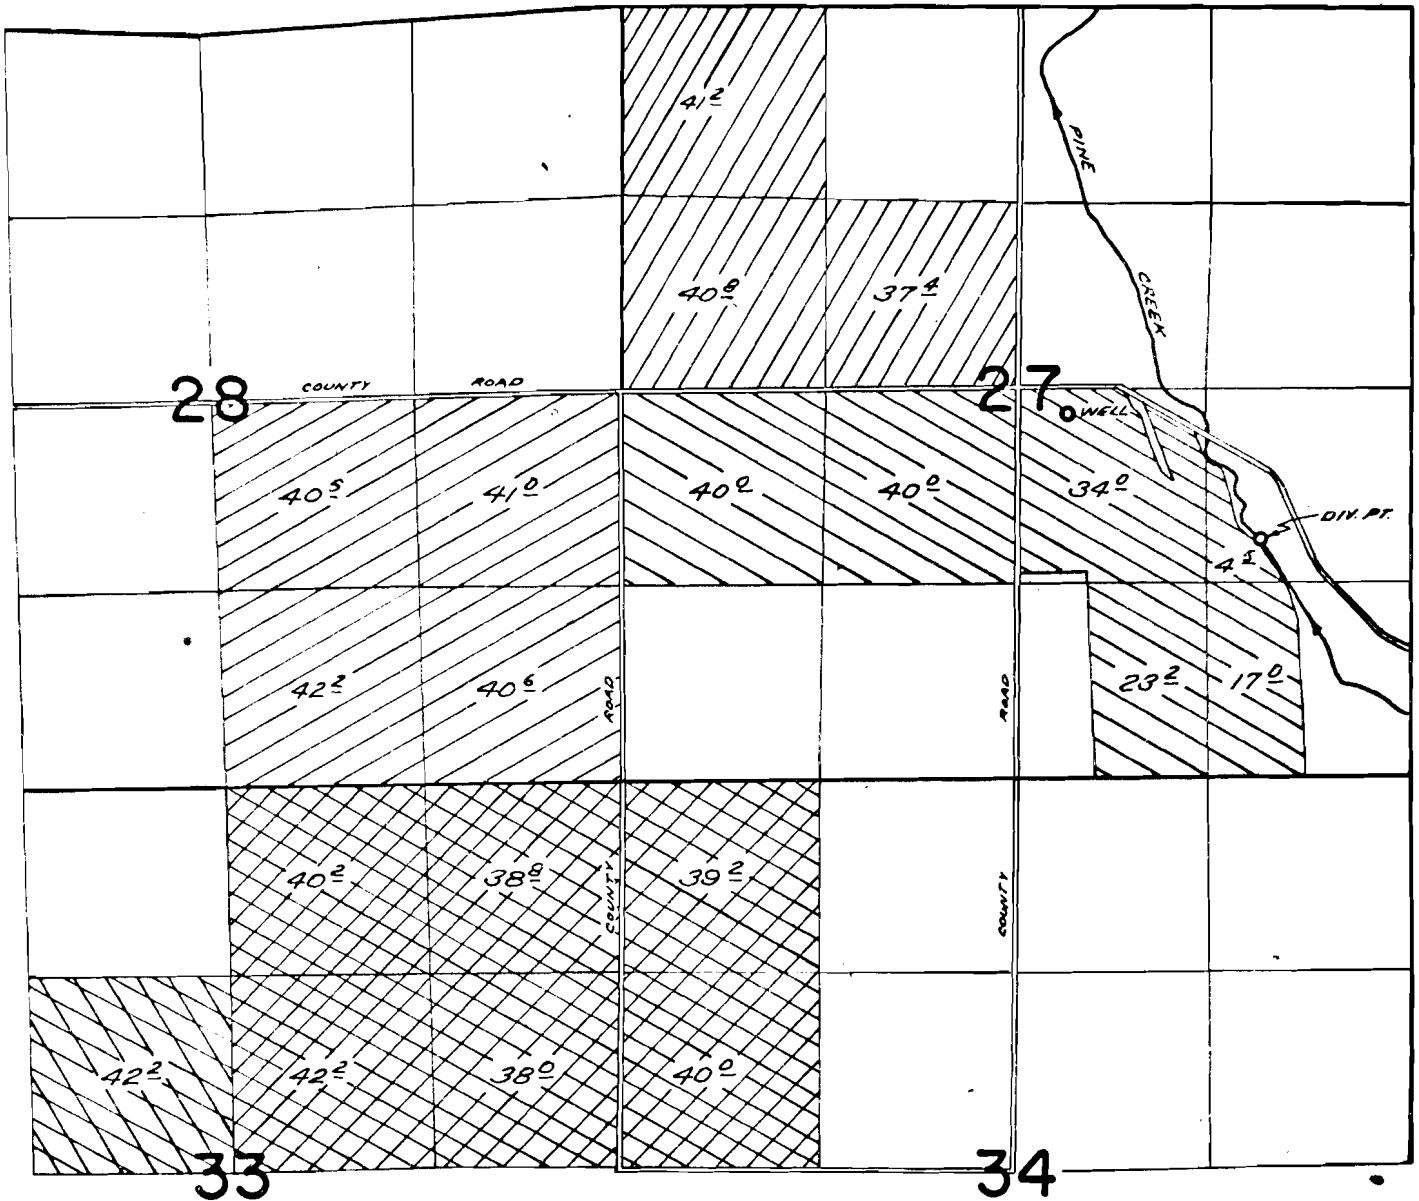

DIV. PT. LOCATED 1010 FT. S. AND 1680 FT. E. FROM CENTER SEC 27
WELL LOCATED 180 FT. S. AND 340 FT. E. FROM CENTER SEC 27

 PER. 34177 & G-4517
  PER. 34176 & G-4516
  PER. 29658
  PER. 33508
  PER. G-3943

FINAL PROOF SURVEY UNDER

33841	29658
44726	33508
45189	34176
45790	34177
6-4876	6-3943
6-4791	6-4516
6-4792	6-4517

Application No. Permit No.

IN NAME OF
DALE ROBERT WOOD
AND ROBERT V. WOOD

Surveyed AUG. 6 1973 by LE. GOULD