


6-4129

4129B

T.6N. R.35&36E W.M.

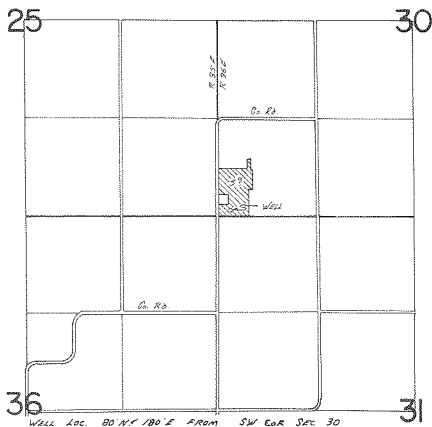

FINAL PROOF SURVEY UNDER

Application No. 6-4129 Permit No. 6-4129
IN NAME OF

ZOLA RAY HUBBS

Surveyed April 17, 1977, by R.G. MUCKEN