


G-4143

41019

# T.2N.R.32E.W.M.

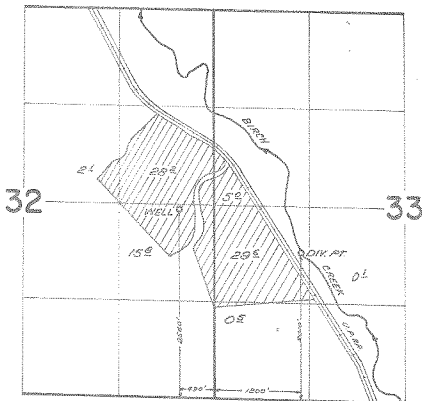

## FINAL PROOF SURVEY UNDER

Application No. G-4385 Permit No. G-4143  
43006 32132

IN NAME OF

CHARLES A. PETERSON

Surveyed Apr. 13 1973 by D.M. Nordy