


G-4304
41020

T.2N.R.33E.W.M.

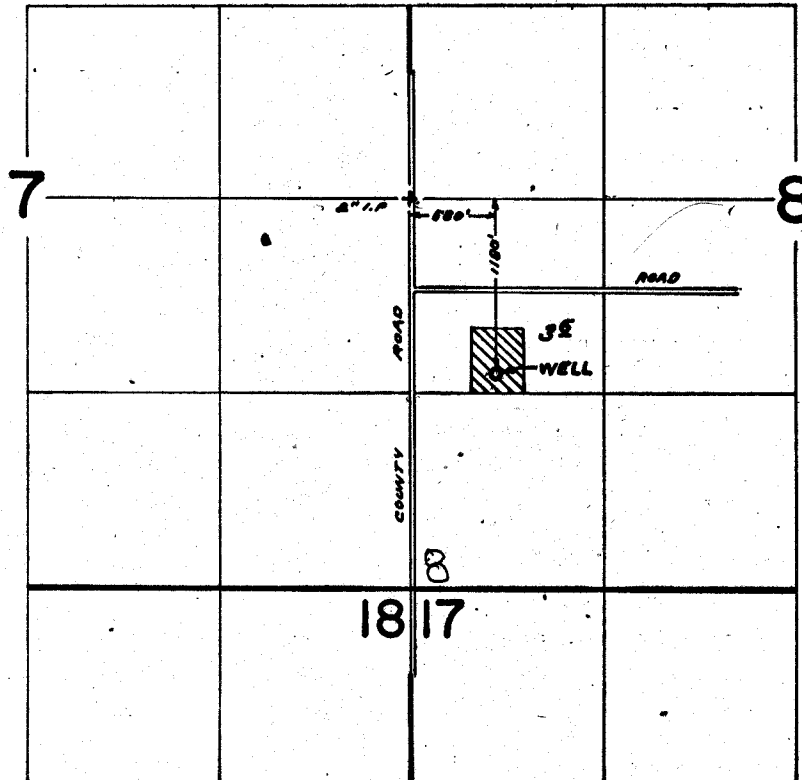

FINAL PROOF SURVEY UNDER

Application No. G-4484 Permit No. G-4304
IN NAME OF

WILLIAM SMETHURST

Surveyed APR. 17 1973, by D.M. NORBY