


6-4391

41072

T.6N. R.35E. WM.

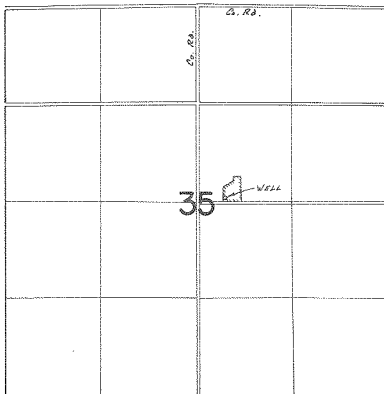

WELL LOC. 70 N. & 970' E FROM CENT. SEC. 35

FINAL PROOF SURVEY UNDER

Application No. 0-4667 Permit No. 0-4391
IN NAME OF

CITY OF MILTON-FREEWATER

Surveyed APRIL 20, 1973, by R.G. Muckey