


T.4N.R.35E.W.M.

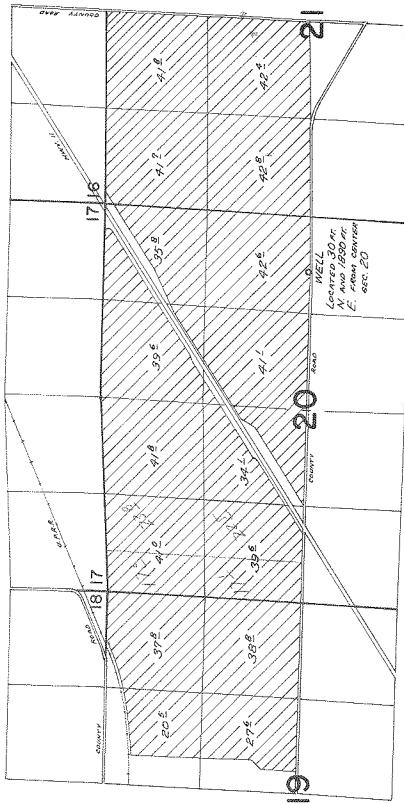

FINAL PROOF SURVEY
UNDER

Application No. G-4730, Permit No. G-4450
IN NAME OF

HAROLD & LOLA BARNETT, INC.

Surveyed Apr. 17, 1973, by R. G. Mucken

G-4450
41623