


T.6N. R.35E. W.M.

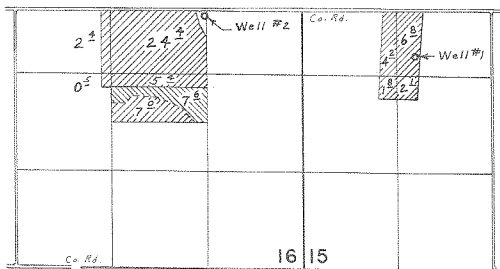

Wells located: #1, 2090' N. & 1060' E.; #2, 3450' N. & 1350' W., both from S.W. Cor. Sec. 15

Primary



Supplemental



FINAL PROOF SURVEY UNDER

Application No. G-5642 Permit No. G-5046
IN NAME OF

ALVIN O. KNOPF

Surveyed Aug. 8, 1973, by L. E. Goulet