


G-5048

41028

T.6N. R.35E. W.M.

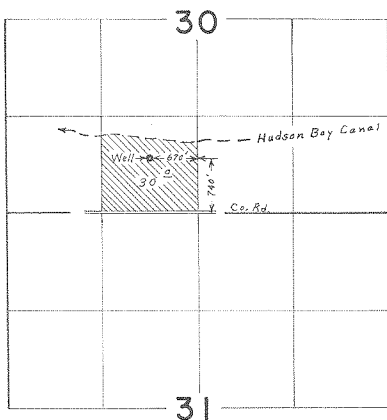

**FINAL PROOF SURVEY**  
UNDER

Application No. G-5961. Permit No. G-5048.

IN NAME OF

**DELBERT & AMY FOX**

Surveyed Aug. 8., 1973, by L. E. Gould.