


T.4 N. R.32 E. W.M.

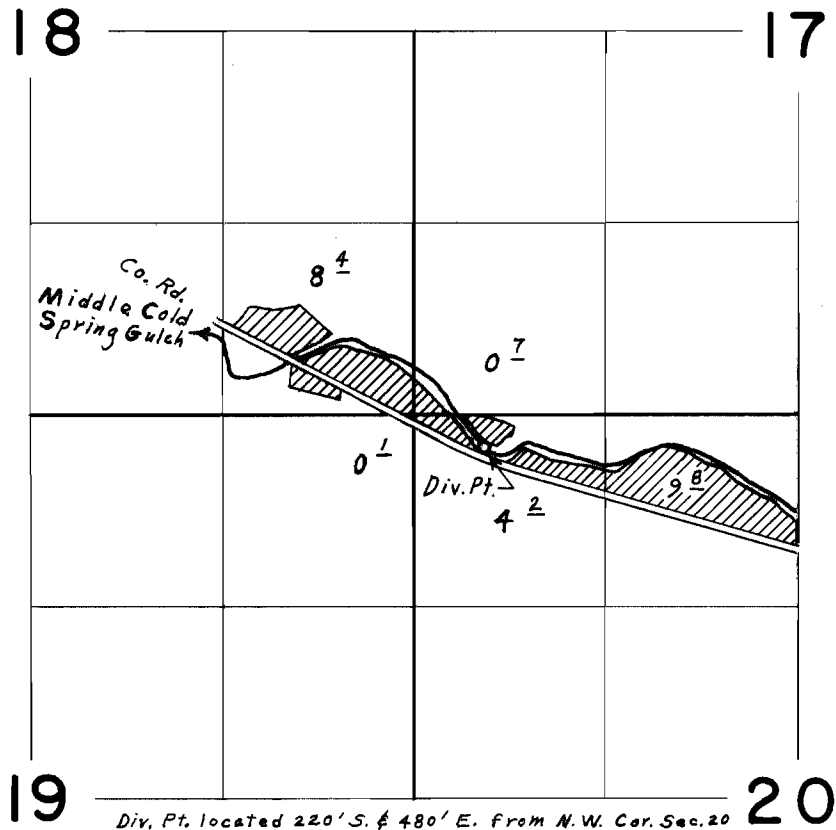

FINAL PROOF SURVEY
UNDER

Application No. 39923 Permit No. 29778
IN NAME OF

MARVIN TUCKER & SONS

Surveyed April 16, 1973, by L. E. Gould