


T.3N.R.34E.W.M.

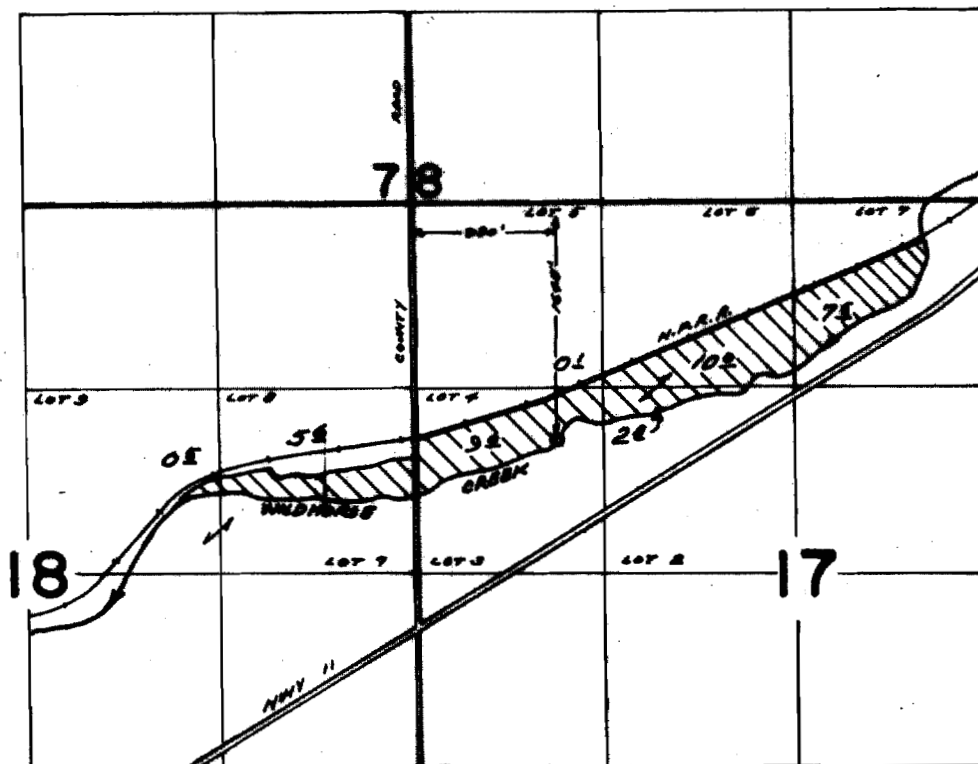

FINAL PROOF SURVEY
UNDER

Application No. 42093 Permit No. 31929
IN NAME OF

H. O. WHITACRE

Surveyed Aug 19 1973, by D. M. NORBY