


T. 1N. & 1S., R. 32E., W.M.

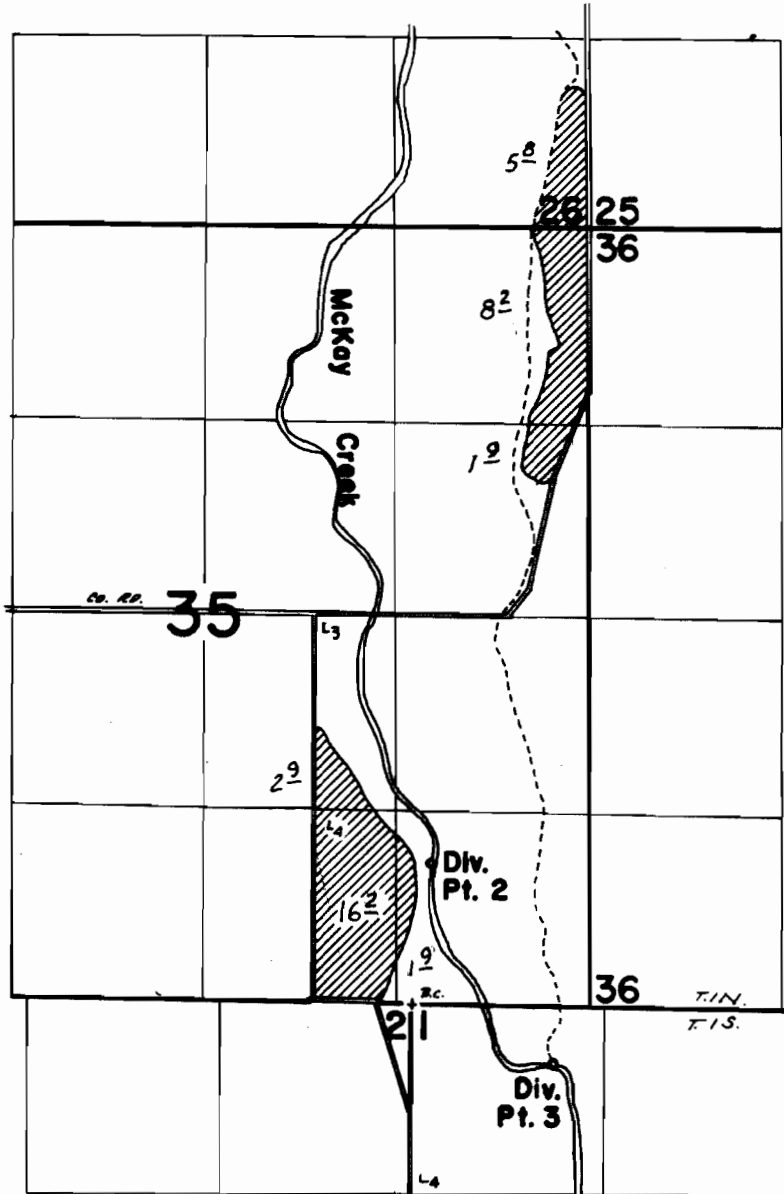

DIV. PTS. LOCATED: #2- 976' N & 100' E; #3- 390' S & 980' E, BOTH FROM NW COR SEC 1.

FINAL PROOF SURVEY
UNDER

Application No. **43542** Permit No. **32571**
IN NAME OF

JAMES S. MILLER

Surveyed **April 12, 1973**, by **D. Norby**