


T.2N.R.33E.W.M.

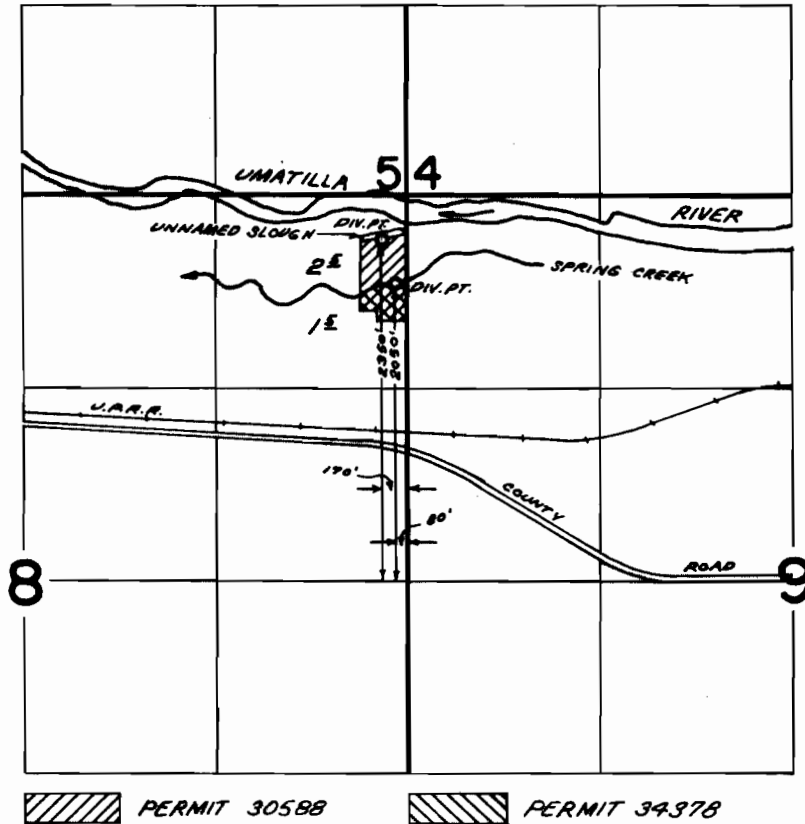

FINAL PROOF SURVEY
UNDER

Application No. 41033 46033 Permit No. 30588 34378
IN NAME OF

ELDON EARL DAVIS

Surveyed APR. 16 1973, by D.M. NORBY