


T.5N. R.28E. W.M.

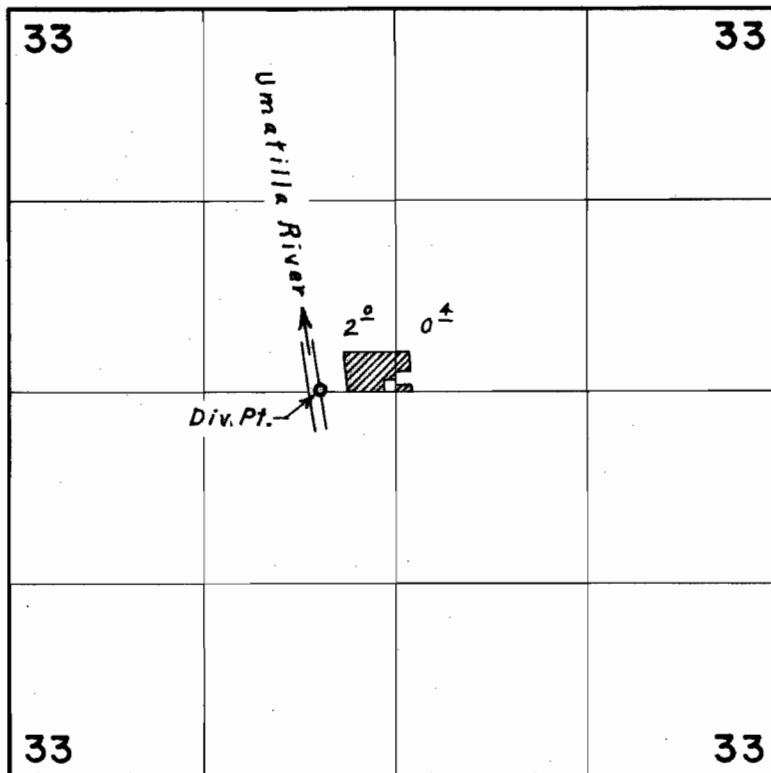

Div. Pt. located 10' N. & 520' W. from Center Sec. 33

FINAL PROOF SURVEY
UNDER

Application No. 48110 Permit No. 36128
IN NAME OF

WALTER BRIGHT

Surveyed April 18, 1974, by L. E. Gould