


T.6S.,R.39E.,W.M.

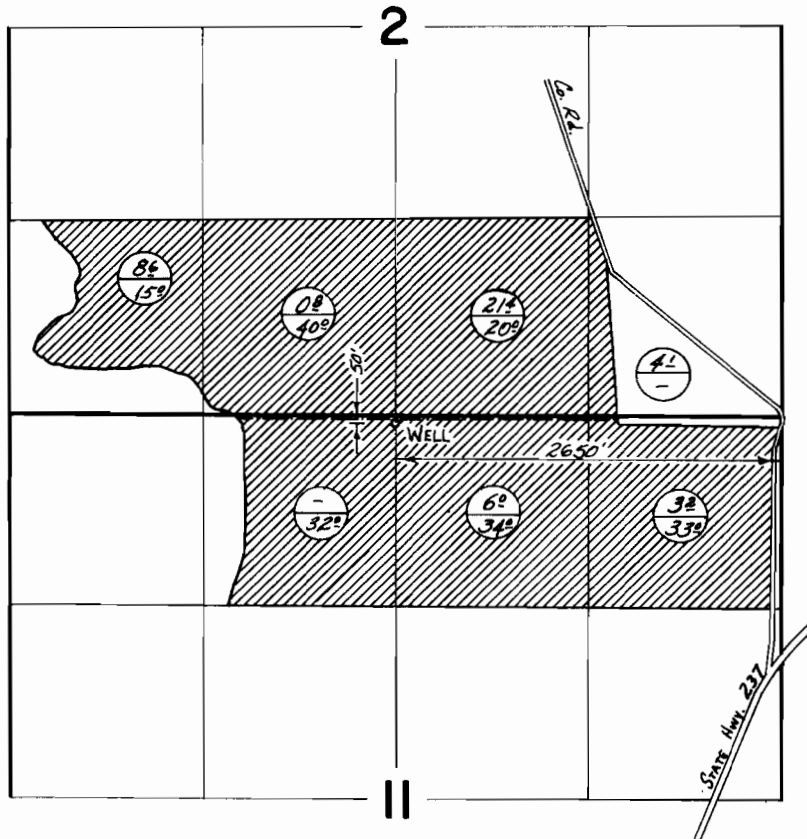

⊕ PRIMARY
⊖ SUPPLEMENTAL

FINAL PROOF SURVEY
UNDER

Application No. G-3196 Permit No. G-3018
IN NAME OF

EUGENE & FRANCES MCINTYRE

Surveyed July 13 1973, by D. NORBY