


T.2S. R.38E. W.M.

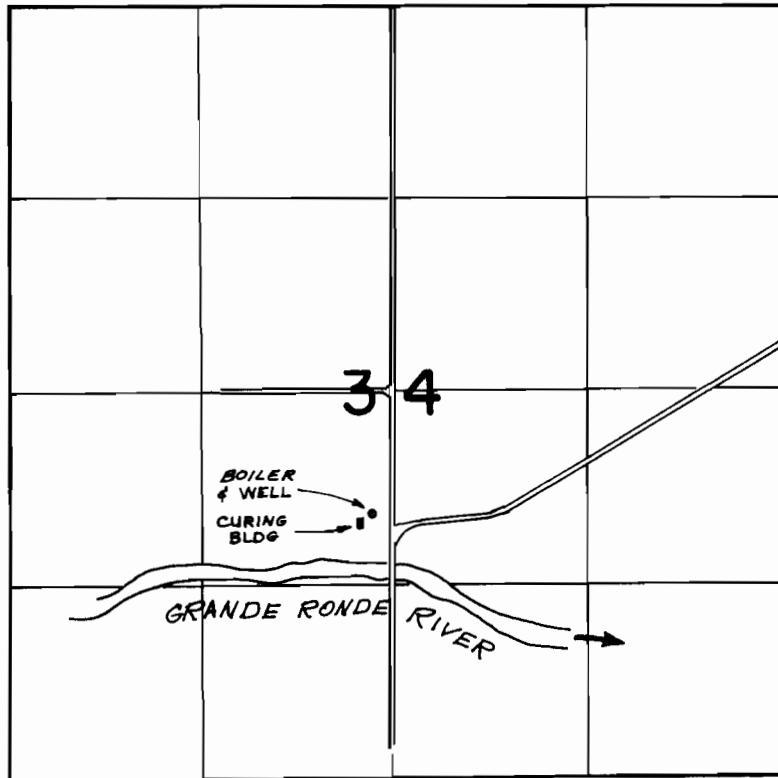

WELL - 840'S., 125'W. FROM CENTER SECTION 34

**FINAL PROOF SURVEY**  
UNDER

Application No. G-3686 Permit No. G-3490  
IN NAME OF

LA GRANDE CONCRETE PIPE CO., INC.

Surveyed July 16 1973, by R. MUCKEN