


T.2&3S.,R.39E.,W.M.

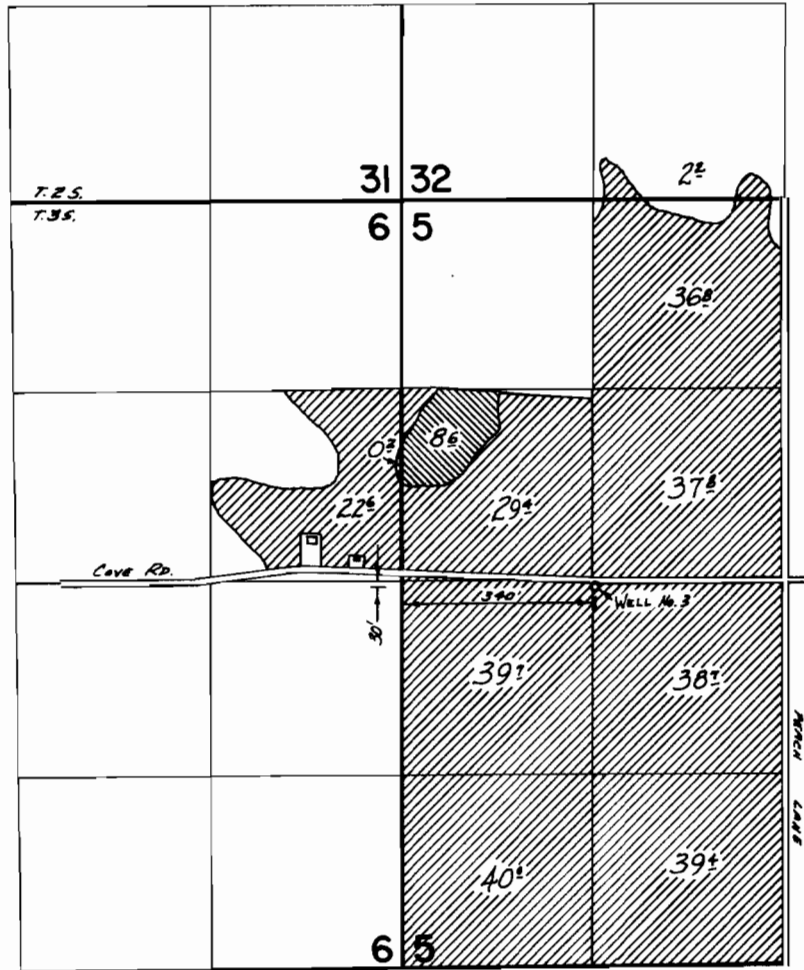

FINAL PROOF SURVEY
UNDER

Application No. G-3874 Permit No. G-3866
IN NAME OF

STANLEY & MAURICE WEISHAAR

Surveyed July 11, 1973, by D. NORBY