


T.3S,R38E.,W.M.

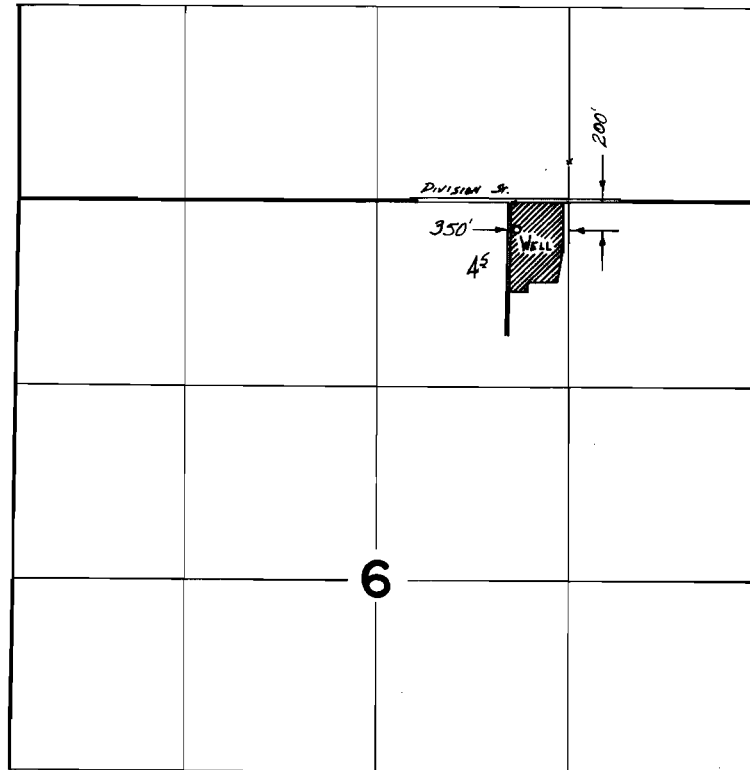

FINAL PROOF SURVEY
UNDER

Application No. G-4627 Permit No. G-4352
IN NAME OF

WILLIAM G. & BETTY F. BLAKENEY

Surveyed July 10 1973, by D. NORBY