


T.1S. R.38E. W.M.

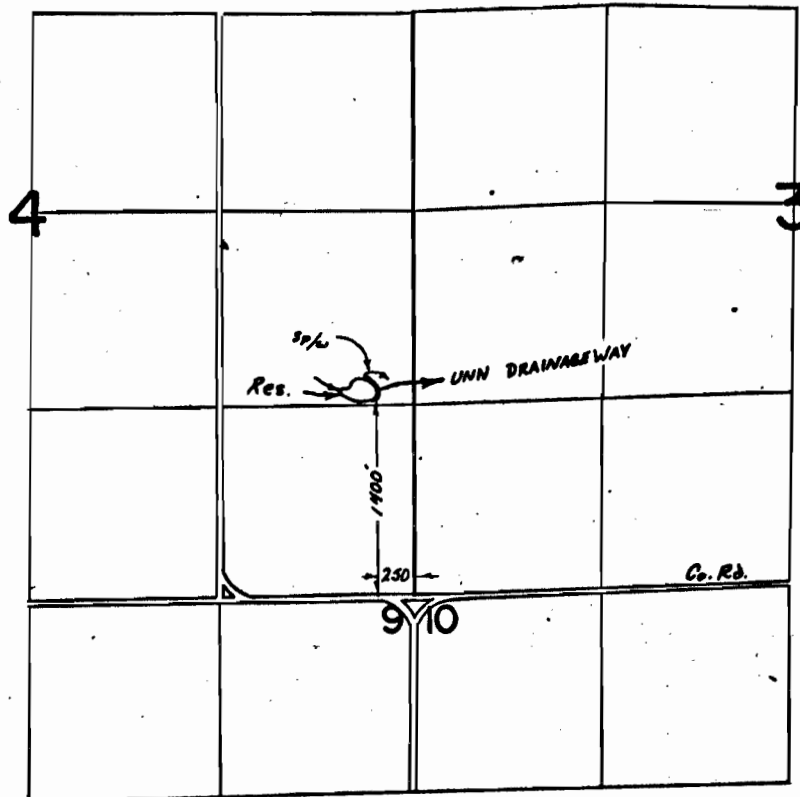

FINAL PROOF SURVEY
UNDER

Application No. R-44997 45376 Permit No. R-5312 33639
IN NAME OF

RALPH H. LONG

Surveyed JULY 11, 1978, by R. B. MUCKEN