


T.2S. R.39E.W.M.

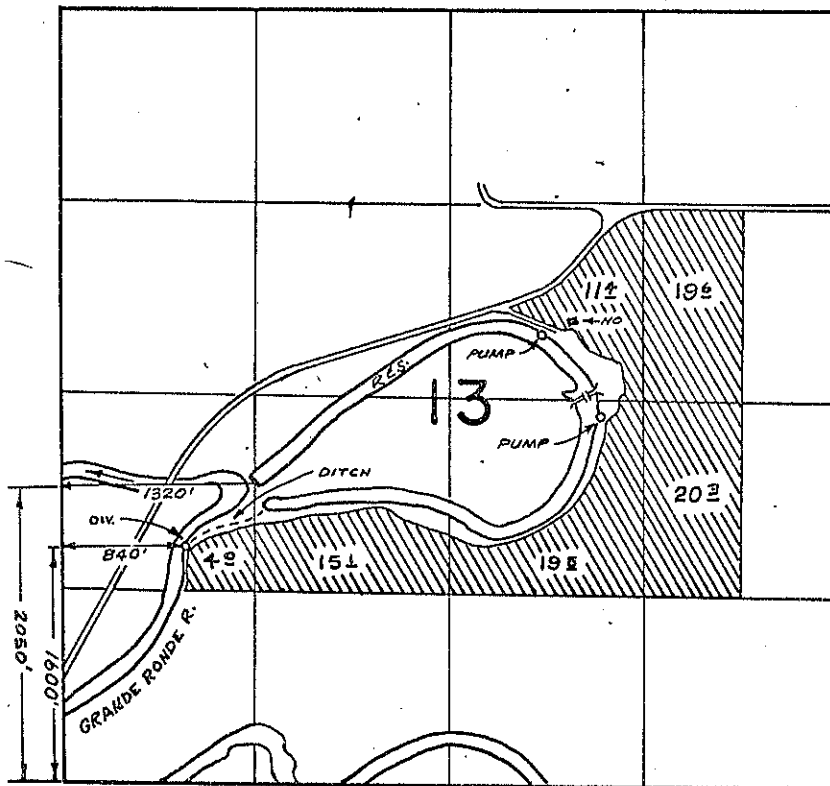

FINAL PROOF SURVEY
UNDER

APPLICATION NO. R-45932 PERMIT NO. R-5463
Application No. ~~45933~~ Permit No. ~~343/5~~
IN NAME OF

ALDON H. GRAY

Surveyed JULY 17 1973, by R. MUCKEN